

BACK OF WALK TABLE		
ROAD NAME	BOW DIMENSION FROM PROPERTY	
RIVERHILLS WAY WEST RIVERGROVE CHASE WEST	1.64m 1.64m	

	LOT TYPE	ELEVATION DIFFERENCE
L	LEVEL LOT	BACK PROPERTY ELEVATION +/- 0.7m DIFFERENCE TO FRONT ELEVATION
SD	SPLIT DRAINAGE	BACK PROPERTY ELEVATION -0.7m TO -1.9m LOWER THAN FRONT ELEVATION
T	TRANSITIONAL LOT	GRADING OF THESE LOTS IS DICTATED BY THE TRANSITION OF A BLOCK FROM LEVEL TO WALKOUT OF FROM SPLIT TO BACK TO FRONT DRAINAGE. BUILDERS SHOULD REVIEW FOUNDATION DESIGNS FOR THESE LOTS ACCORDINGLY.
W	FULL WALKOUT LOT	BACK PROPERTY ELEVATION -1.9m TO -2.5m LOWER THAN FRONT ELEVATION
BF	BACK TO FRONT LOT	BACK PROPERTY ELEVATION +1.0m TO +1.7m HIGHER THAN FRONT ELEVATION
BFS	BACK TO FRONT SPLIT LOT	BACK PROPERTY ELEVATION +0.7m TO +1.0m HIGHER THAN FRONT ELEVATION

Note

General Notes

- SAN SERVICES TO BE 100mm DIA DR-28 PVC WHITE
 STORM SERVICES TO BE 38mm DIA CTS SERIES 160 POLYETHYLENE PIPE -
- 3. ALL LOTS REQUIRE A BUILDING SUMP PUMP. CONNECT PRESSURIZED PUMP DISCHARGE LINE TO STORM AS PER MANUFACTURERS SPECIFICATIONS.
- 4. WATER SERVICES TO BE 25mm DIA UNLESS SHOWN OTHERWISE.5. ALL SERVICES ARE LOCATED ON LOT AS DIMENSIONED.


INTENTION TO CARRY OUT ITS OPERATIONS.

- 6. REFER TO THE SUBDIVISION UTILITY AND OVERLAND DRAINAGE RIGHT OF WAY PLANS FOR LOCATIONS AND DIMENSIONS OF RIGHT OF WAYS ON
- 7. ALL CURB BOXES TO BE 2.15m 2.45m DEEP AS PER CITY OF LETHBRIDGE SPECIFICATIONS.
- THE EXISTENCE, LOCATION AND ELEVATION OF UTILITIES, AND/OR CONCEALED STRUCTURES AT THE PROJECT SITE ARE NOT GUARANTEED BY THE ENGINEER. THE CONTRACTOR IS RESPONSIBLE FOR DETERMINING THE EXISTENCE, LOCATION, AND ELEVATION OF ALL SUCH UTILITIES AND/OR STRUCTURES AND IS RESPONSIBLE FOR NOTIFYING THE APPROPRIATE COMPANY, DEPARTMENT, OR PERSON(S) OF ITS

Home Builder Notes

1. ALL ELEVATIONS IDENTIFIED ON THIS DRAWING MUST BE VERIFIED PRIOR TO BUILDING DEVELOPMENT. IT IS RECOMMENDED THAT THE LOT DEVELOPER CONFIRM ALL ONSITE GRADING, SERVICE LOCATIONS AND SANITARY INVERTS PRIOR TO COMPLETING BUILDING DESIGN AND FOUNDATION INSTALLATION. INTERNAL LOT GRADING SETBACKS WILL REMAIN RELATIVE TO THOSE GRADES ESTABLISHED BY SIDEWALKS, LANES AND SWALES ENCOUNTERED ONSITE.

2. HOME BUILDER TO SET ACTUAL TOP OF FOOTINGS AND LANDSCAPE GRADES SUCH THAT POSITIVE SURFACE DRAINAGE IS MAINTAINED AWAY FROM THE HOUSE FOUNDATION WALL TOWARD PUBLIC RIGHTS OF WAY. REFER TO THE CITY OF LETHBRIDGE DESIGN STANDARDS SECTION "POST LOT DEVELOPMENT".

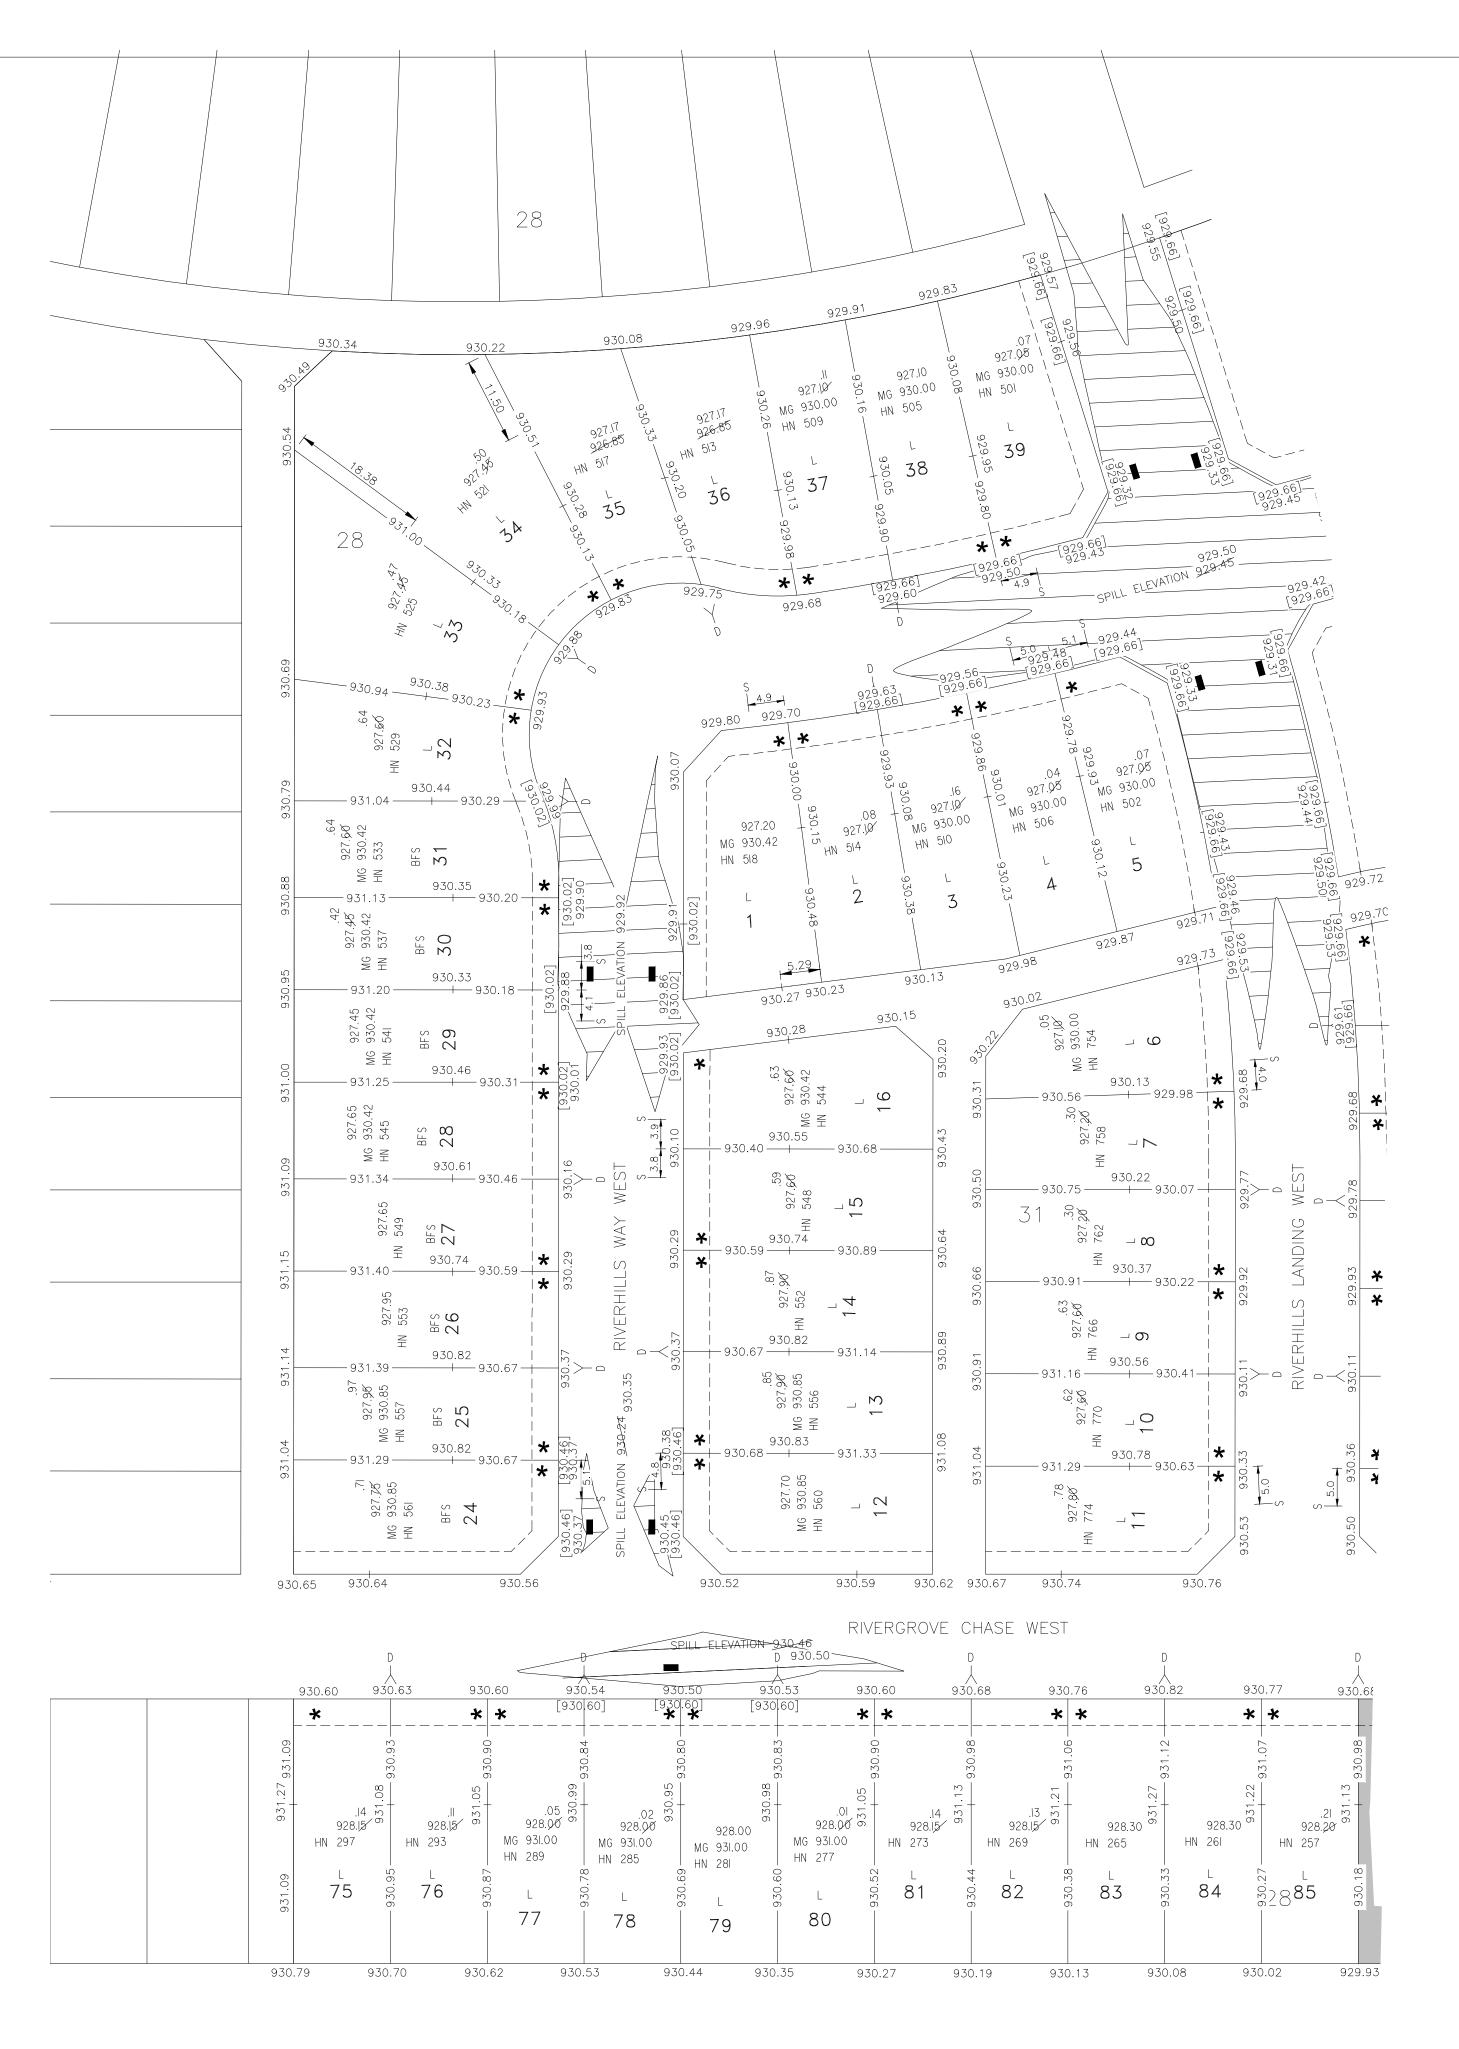



Stanted

Stantec Suite 290, 220 - 4th Street South Lethbridge, Alberta Canada

Tel. 403.329.3344

www.stantec.com

Copyright Reserved

The Contractor shall verify and be responsible for all dimensions. DO NOT scale the drawing - any errors or omissions shall be reported to Stantec without delay.

The Copyrights to all designs and drawings are the property of

The Copyrights to all designs and drawings are the property of Stantec. Reproduction or use for any purpose other than that authorized by Stantec is forbidden.

Leger

FILLS GREATER THAN 1.2m

Notes

STREET		
- [918.82] •	918.7 <u>2</u> [918.82]	CURB
		150
	8	DIST. TO BACK OF VARIES BY ROAD B
- 6 - 8 - 8 - 8 - 8 - 8	918.9 	DIS
- 7 916.40	- 78.	
– [∞]	2 6 7	
- 18.94	18.87	
	BAC	
_	.0m	
918.74	918.67	
	918.78 - 918.82] - ** - 86.816 - 46.816 -	918.72 918.82] 918.82] 918.82] 918.82 916.40 MG 919.32 HN 108 L 92

F	Re-Issued for As-Built		CB	BS	2019.03.25
Е	Issued for As-Built		RSW	BS	18.10.02
D	Issued for Construction		AB	BS	2017.10.19
С	Issued for Quotation		AB	BS	2017.09.15
В	Issued for Approval		SB	BS	2017.07.25
Α	Issued for Approval		BS	MVD	2014.01.10
Issu	ued		Ву	Appd.	YY.MM.DD
File	Name: 35577	SB	BS	BS	2014.01.10
		Dwn.	Chkd.	Dsgn.	YY.MM.DD

Permit-Seal



Client/Project

 $.. \hdots ... \hdots$

RIVERSTONE PHASE 21

LETHBRIDGE, ALBERTA CANADA

Titlo

Lot Grading Plan & Details Phase 21B

Project No. 112935577	Scale 0 5	15 25m
Drawing No.	Sheet	Issue/Revision
C102.2	4 of 14	F/